
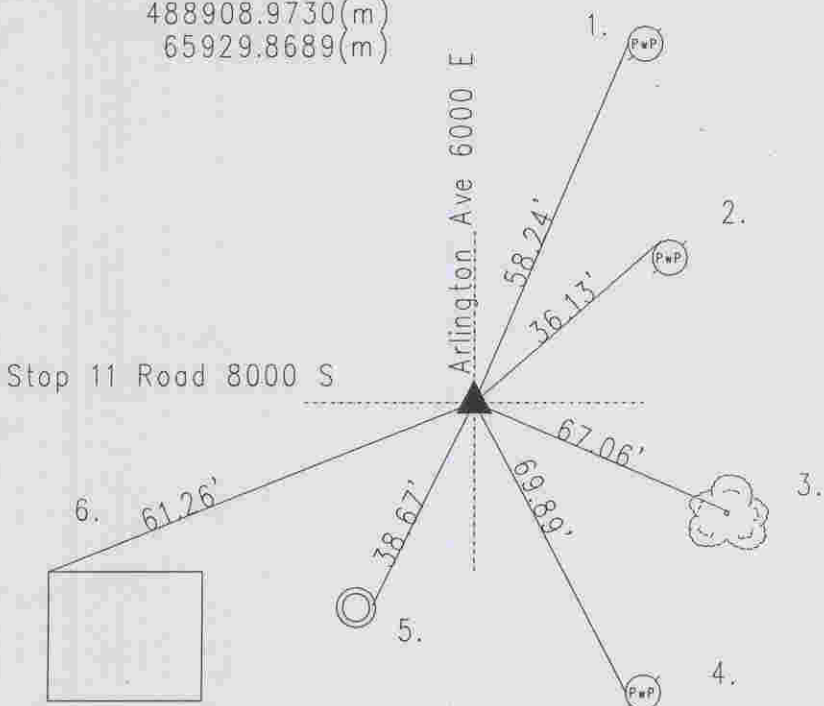


OFFICE OF THE MARION COUNTY SURVEYOR  
SECTION RECORD CORNER  
SECTION 23 TOWNSHIP 14 RANGE 4  
DATE: 4-1-05  
PARTY CHIEF: Wilcoxon  
CREW: \_\_\_\_\_  
TYPE OF MARKER: Harrison  
METHOD OF ESTABLISHMENT: County: 3-31-00

IN. S.P.C. E ZONE NAD '83  
NAME: 14042301  
N: 488908.9730(m)  
E: 65929.8689(m)

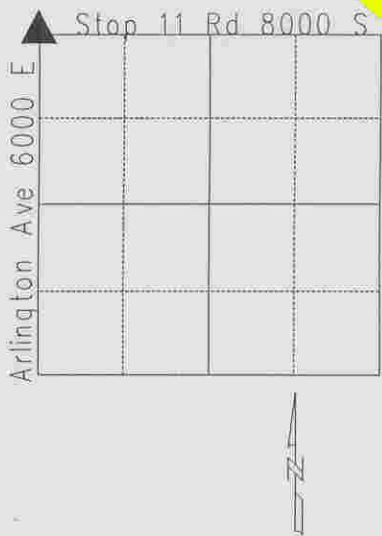

Original post set 1820 by hendricks with no witness recorded per Marion County Atlas pg. 9. Hosbrook 11-10-1849 for 22-14-4 notes both stumps very plain and records a new witness: 36" black oak N 55 S 118 links per Franklin Township Legal Survey Book pg. 26. Hosbrook 2-20-1852 plats a point '6' per Franklin Township Legal Survey Book pg. 25 and for SE 15-14-4. 6-26-1894 Julian for NE 22 and NW 23-14-4 called stone set previously. No witness recorded per Franklin Township Legal Survey Book pg. 51. Tie card 11-5-52 by Monroe called stone. Tie card 8-25-68 called Johnson County marker. 7-14-75 called PK nail at surface. 5-9-85 set Harrison. Re-tied 8-25-68, 9-20-79, 7-14-75, 5-9-85 & 4-1-05. 14042301

REF.	DISTANCE	DESCRIPTION
1.	58.24'	PK nail W PwP#66-796 6"up
2.	36.13'	Mag nail w/brass washer NW PwP#4-796 10"up
3.	67.06'	Boat spike N 18" mulberry 6"up
4.	69.89'	Mag nail w/brass washer E PwP#68-796
5.	38.67'	Cut 'x' F rim sewer manhole
6.	61.26'	NW corner of concrete bell telephone pad